

webster
baldwin
day
rohrman


architects
engineers

Bangor, Maine

1494

N.M.V.T.I.
SHOP

PRESQUE ISLE
MAINE

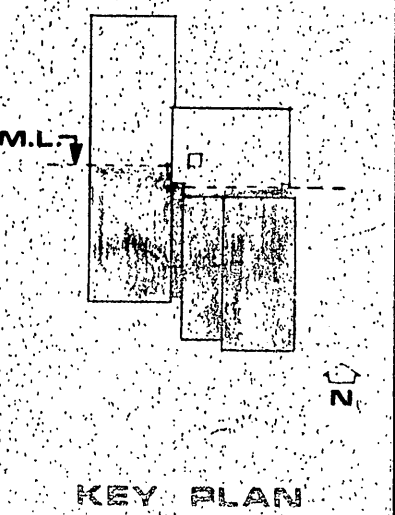


NO. REVISION DATE

A AS-BUILT 5-1-83

DESIGNER	HD-SR
ENGINEER	JMR
DRAWN BY	RLR
CHECKED BY	JMR
DATE	JUNE 1, 1981

SOUTH
LOWER
LEVEL
PLUMBING
PLAN
SCALE: 1/8" = 1'-0"

P-2

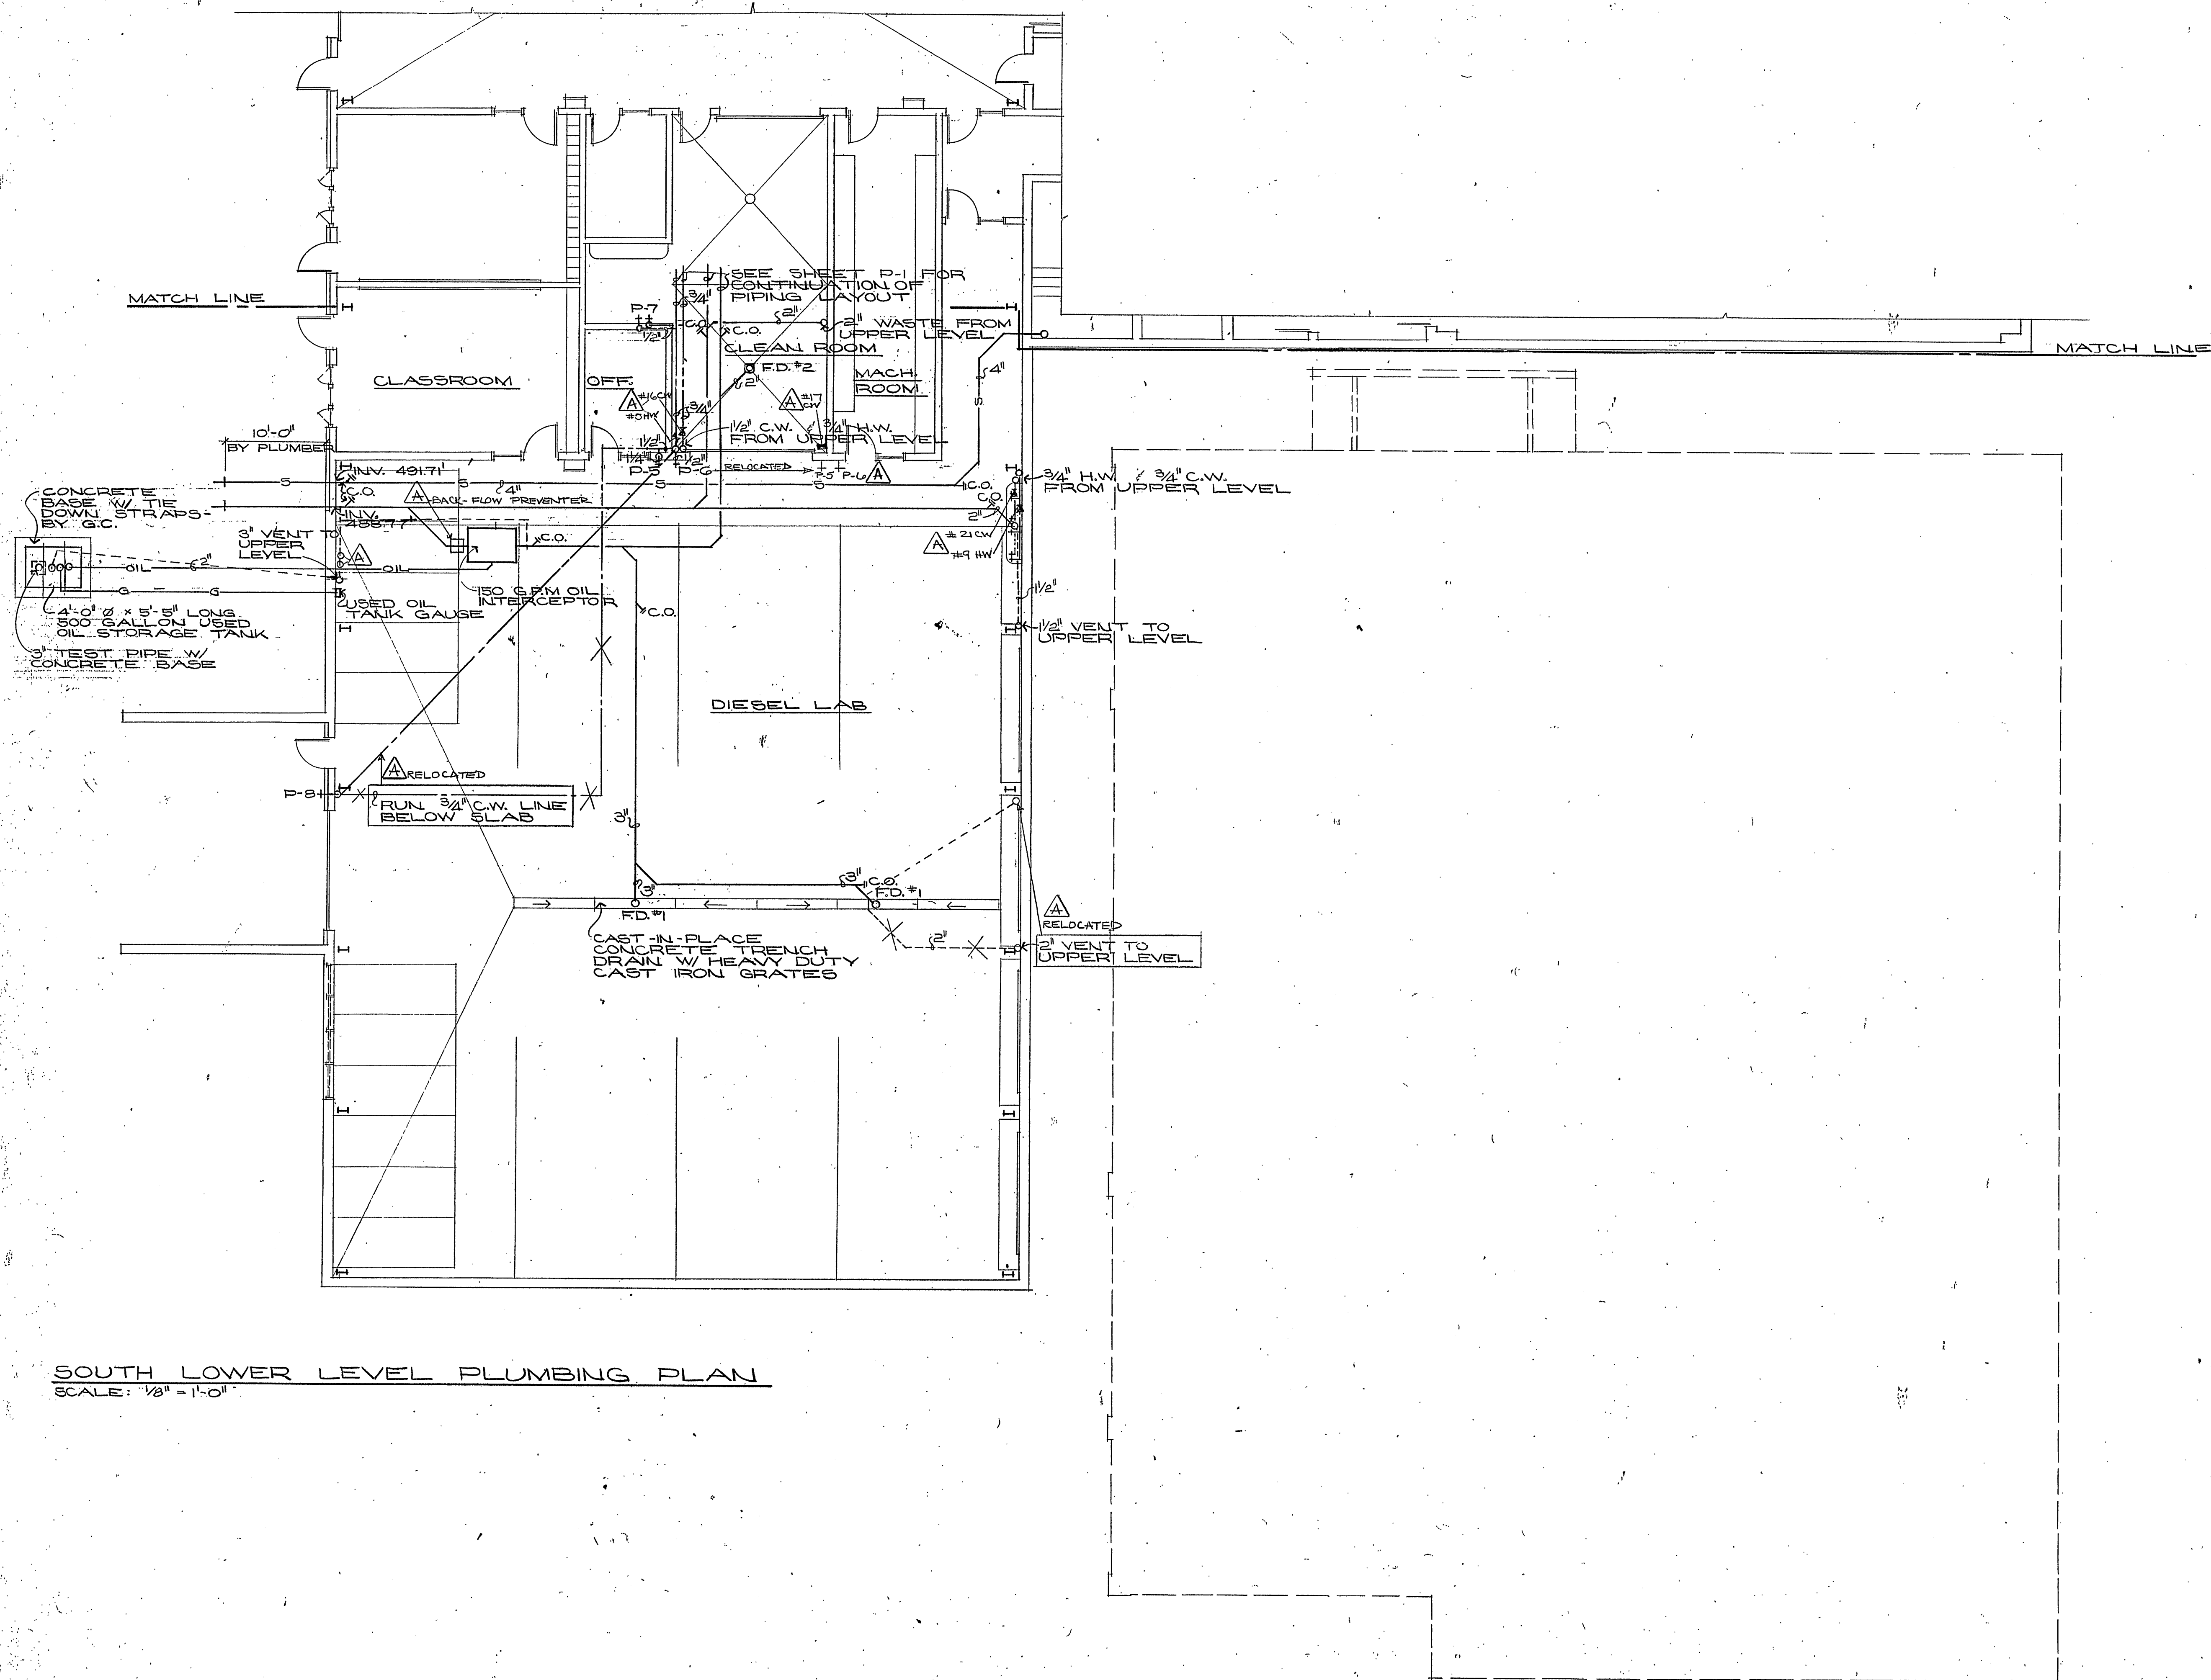

SOUTH LOWER LEVEL PLUMBING PLAN
SCALE: 1/8" = 1'-0"